

ELEVATION CERTIFICATE

Important: Read the instructions on pages 1 - 7.

SECTION A - PROPERTY OWNER INFORMATION

BUILDING OWNER'S NAME		For Insurance Company Use:	
BUILDING STREET ADDRESS (Including Apt., Unit, Suite, and/or Bldg. No.) OR P.O. ROUTE AND BOX NO. CLIFTON ROAD		Policy Number	
CITY BARNEGAT	STATE NEW JERSEY	Company NAIC Number	
PROPERTY DESCRIPTION (Lot and Block Numbers, Tax Parcel Number, Legal Description, etc.) TAX MAP 63 BLOCK 199 BARNEGAT TOWNSHIP OCEAN CO. NJ.		ZIP CODE 08005	
BUILDING USE (e.g., Residential, Non-residential, Addition, Accessory, etc. Use a Comments area, if necessary.) RESIDENTIAL			
LATITUDE/LONGITUDE (OPTIONAL) (##°-##'-###" or ###.####")		HORIZONTAL DATUM: <input type="checkbox"/> NAD 1927 <input type="checkbox"/> NAD 1983	
		SOURCE: <input type="checkbox"/> GPS (Type): <input type="checkbox"/> USGS Quad Map <input type="checkbox"/> Other	

SECTION B - FLOOD INSURANCE RATE MAP (FIRM) INFORMATION

B1. NFIP COMMUNITY NAME & COMMUNITY NUMBER TOWNSHIP OF BARNEGAT 340396		B2. COUNTY NAME OCEAN COUNTY		B3. STATE N.J.	
B4. MAP AND PANEL NUMBER 0021	B5. SUFFIX C	B6. FIRM INDEX DATE 5/31/1974	B7. FIRM PANEL EFFECTIVE/REVISED DATE 12/15/1982	B8. FLOOD ZONE(S) AS	B9. BASE FLOOD ELEVATION(S) (Zone AO, use depth of flooding) 7'

B10. Indicate the source of the Base Flood Elevation (BFE) data or base flood depth entered in B9.
☐ FIS Profile ☒ FIRM ☐ Community Determined ☐ Other (Describe):B11. Indicate the elevation datum used for the BFE in B9: ☒ NGVD 1929 ☐ NAVD 1988 ☐ Other (Describe):B12. Is the building located in a Coastal Barrier Resources System (CBRS) area or Otherwise Protected Area (OPA)? ☐ Yes ☒ No
Designation Date:

SECTION C - BUILDING ELEVATION INFORMATION (SURVEY REQUIRED)

C1. Building elevations are based on: ☐ Construction Drawings* ☐ Building Under Construction* ☒ Finished Construction
*A new Elevation Certificate will be required when construction of the building is complete.

C2. Building Diagram Number 2 (Select the building diagram most similar to the building for which this certificate is being completed - see pages 6 and 7. If no diagram accurately represents the building, provide a sketch or photograph.)

C3. Elevations - Zones A1-A30, AE, AH, A (with BFE), VE, V1-V30, V (with BFE), AR, AR/A, AR/AE, AR/A1-A30, AR/AH, AR/AO
Complete Items C3.a-i below according to the building diagram specified in Item C2. State the datum used. If the datum is different from the datum used for the BFE in Section B, convert the datum to that used for the BFE. Show field measurements and datum conversion calculation. Use the space provided or the Comments area of Section D or Section G, as appropriate, to document the datum conversion.
Datum 1929 NGVD Conversion/Comments PREVIOUS VERTICAL LOOP BETWEEN VERTICAL GEODETIC REFERENCES
Elevation reference mark used RM#2 (3.2.808) Does the elevation reference mark used appear on the FIRM? ☒ Yes ☐ No

<input type="checkbox"/> a) Top of bottom floor (including basement or enclosure)	<u>5.0</u> ft.(m)
<input type="checkbox"/> b) Top of next higher floor	<u>9.4</u> ft.(m)
<input type="checkbox"/> c) Bottom of lowest horizontal structural member (V zones only)	<u>N/A</u> ft.(m)
<input type="checkbox"/> d) Attached garage (top of slab)	<u>6.3</u> ft.(m)
<input type="checkbox"/> e) Lowest elevation of machinery and/or equipment servicing the building (Describe in a Comments area.)	<u>8.8</u> ft.(m)
<input type="checkbox"/> f) Lowest adjacent (finished) grade (LAG)	<u>5.5</u> ft.(m)
<input type="checkbox"/> g) Highest adjacent (finished) grade (HAG)	<u>6.2</u> ft.(m)
<input type="checkbox"/> h) No. of permanent openings (flood vents) within 1 ft. above adjacent grade	<u>4</u>
<input type="checkbox"/> i) Total area of all permanent openings (flood vents) in C3.h	<u>2704</u> sq. in. (sq. cm)

SEE COMMENTS 1+2

NJPLS # 27486

3/21/2005

SECTION D - SURVEYOR, ENGINEER, OR ARCHITECT CERTIFICATION

This certification is to be signed and sealed by a land surveyor, engineer, or architect authorized by law to certify elevation information.
I certify that the information in Sections A, B, and C on this certificate represents my best efforts to interpret the data available.
I understand that any false statement may be punishable by fine or imprisonment under 18 U.S. Code, Section 1001.

CERTIFIER'S NAME WILLIAM C. ENDRISS		LICENSE NUMBER NJPLS # 27486	
TITLE LAND SURVEYOR	COMPANY NAME DOLAN- ENDRISS ASSOC. P.A.	CITY FORKEO RIVER	STATE NJ
ADDRESS 651 WEST LACEY ROAD	ZIP CODE 08731	DATE 3/21/2005	TELEPHONE 609-693-6452
SIGNATURE <i>William C. Endriss</i>			

IMPORTANT: In these spaces, copy the corresponding information from Section A.

BUILDING STREET ADDRESS (Including Apt., Unit, Suite, and/or Bldg. No.) OR P.O. ROUTE AND BOX NO.

CITY

STATE

ZIP CODE

CLIFTON ROAD

BARNEGAT

NJ.

08005

For Insurance Company Use:

Policy Number

Company NAIC Number

SECTION D - SURVEYOR, ENGINEER, OR ARCHITECT CERTIFICATION (CONTINUED)

Copy both sides of this Elevation Certificate for (1) community official, (2) insurance agent/company, and (3) building owner.

COMMENTS

①. C3h & C3i 4 (VELCRO DOORS) are attached to CRAWLERS OPENINGS FOR CRAWL SPACE. ② GARAGE HAS 5 ADDITIONAL VENTS 12"x12" or 720 sq INCHES. ③ MECHANICAL C3c ARE IN GARAGE & RAISED TO ELEVATION 88.4 & 9.3. ④ OUTSIDE AIR CONDITIONER CFW 9.1 ⑤ ALL ELEVATIONS N.G.U.D. 1929

☐

Check here if attachments

SECTION E - BUILDING ELEVATION INFORMATION (SURVEY NOT REQUIRED) FOR ZONE AO AND ZONE A (WITHOUT BFE)

For Zone AO and Zone A (without BFE), complete Items E1. through E5. If the Elevation Certificate is intended for use as supporting information for a LOMA or LOMR-F, Section C must be completed.

E1. Building Diagram Number (Select the building diagram most similar to the building for which this certificate is being completed – see pages 6 and 7. If no diagram accurately represents the building, provide a sketch or photograph.)

E2. The top of the bottom floor (including basement or enclosure) of the building is ft. (m) in. (cm) above or below (check one) the highest adjacent grade. (Use natural grade, if available.)

E3. For Building Diagrams 6-8 with openings (see page 7), the next higher floor or elevated floor (elevation b) of the building is ft. (m) in. (cm) above the highest adjacent grade. Complete Items C3.h and C3.i on front of form.

E4. The top of the platform of machinery and/or equipment servicing the building is ft. (m) in. (cm) above or below (check one) the highest adjacent grade. (Use natural grade, if available.)

E5. For Zone AO only: If no flood depth number is available, is the top of the bottom floor elevated in accordance with the community's floodplain management ordinance? Yes No Unknown. The local official must certify this information in Section G.

SECTION F - PROPERTY OWNER (OR OWNER'S REPRESENTATIVE) CERTIFICATION

The property owner or owner's authorized representative who completes Sections A, B, C (Items C3.h and C3.i only), and E for Zone A (without a FEMA-issued or community-issued BFE) or Zone AO must sign here. The statements in Sections A, B, C, and E are correct to the best of my knowledge.

PROPERTY OWNER'S OR OWNER'S AUTHORIZED REPRESENTATIVE'S NAME

ADDRESS

CITY

STATE

ZIP CODE

SIGNATURE

DATE

TELEPHONE

COMMENTS

SECTION G - COMMUNITY INFORMATION (OPTIONAL)

The local official who is authorized by law or ordinance to administer the community's floodplain management ordinance can complete Sections A, B, C (or E), and G of this Elevation Certificate. Complete the applicable item(s) and sign below.

G1. The information in Section C was taken from other documentation that has been signed and embossed by a licensed surveyor, engineer, or architect who is authorized by state or local law to certify elevation information. (Indicate the source and date of the elevation data in the Comments area below.)

G2. A community official completed Section E for a building located in Zone A (without a FEMA-issued or community-issued BFE) or Zone AO.

G3. The following information (Items G4-G9) is provided for community floodplain management purposes.

G4. PERMIT NUMBER

G5. DATE PERMIT ISSUED

G6. DATE CERTIFICATE OF COMPLIANCE/OCCUPANCY ISSUED

G7. This permit has been issued for: New Construction Substantial Improvement

G8. Elevation of as-built lowest floor (including basement) of the building is: ft. (m) Datum:

G9. BFE or (in Zone AO) depth of flooding at the building site is: ft. (m) Datum:

LOCAL OFFICIAL'S NAME

TITLE

COMMUNITY NAME

TELEPHONE

SIGNATURE

DATE

COMMENTS

NOTE: The mean high water line shown herein represents conditions as of the date of this survey. No attempt was made to determine if any portion of this property is claimed by the State of New Jersey as tidelands.


HACKENSACK

LAGOON

Bearing ref. file map #C-51

LEGEND

T.M. Tax map
F.M. File map
P.O.B. Point of beginning
Conc. Concrete
Fnd. Found
E/P Edge of pavement
BH Bulkhead
C. Centerline
Mon. Monument
Spot Elevation
F. Low water
TOP of CURB
GUTTER

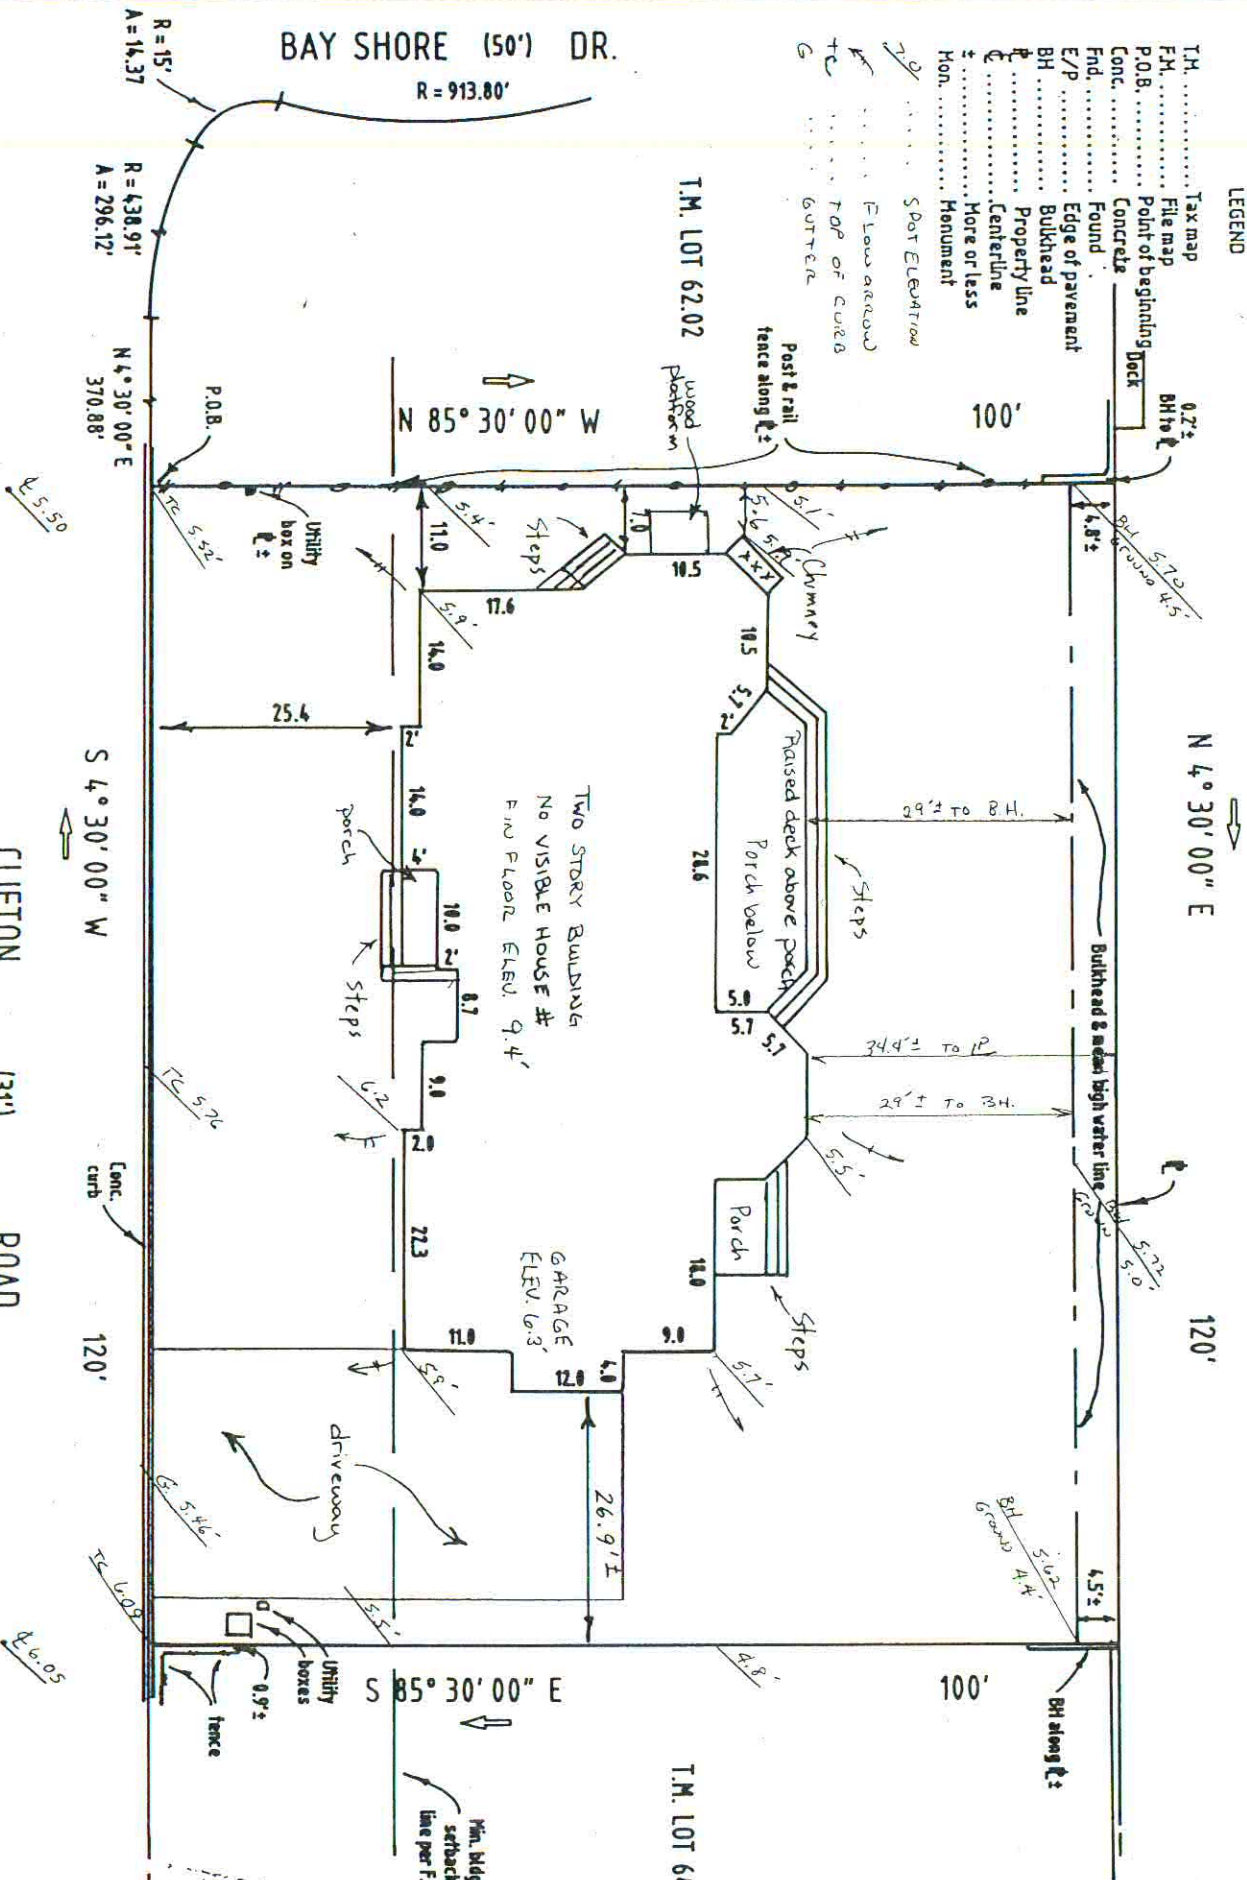

REFERENCES

- A. File map # C-51.
- B. File map # G-1462.
- C. Survey by Fazy, P.L.S. & P.P. dated 9/12/2000.
- D. Barnegat Twp., O.C., NJ tax map sheet # 134 (rev. 2/28/1994).
- E. Firm panel 0827C (community # 340396).

NOTES

1. Dimensions shown in feet & decimals thereof.
2. Lot area 12,008 sq. ft. per file map datum (11,200± sq. ft. of upland area at time of survey).
3. Building dimensions & location shown to foundation and are to the nearest 0.1'±.
4. Utilities/services appear to be situated underground.
5. NO CORNERS SET/NOT FOR TITLE TRAVELER.
6. ALL ELEVATIONS N.G.U.D. 1929

DESCRIPTION

Being lots 208 & 209 on Clifton Road as shown on a map entitled "Section 'C' Subdivision Map Indian Surf Beach" filed in the O.C.C.O. on 10/31/1956 as file map # C-51.

LEGEND

T.M. Tax map
F.M. File map
P.O.B. Point of beginning
Conc. Concrete
Fnd. Found
E/P Edge of pavement
BH Bulkhead
C. Centerline
Mon. Monument
R. Radius
A. Arc length

This survey is a representation of conditions existing on the property except such easements and encroachments, if any, that may be located below the surface of the land or on the surface of the land not visible or in documentation supplied at the time of survey. This survey is made only to named parties for purchase and/or mortgage of delineated property by named purchaser. No responsibility or liability is assumed by surveyor for use of survey for any other purpose including, but not limited to, use of survey for survey affidavit, resale of property, or to any other person not listed above either directly or indirectly. Unauthorized alteration or addition to a survey map bearing a licensed land surveyor seal is illegal and punishable by law. This survey does not delineate, note, show, indicate or determine any wetlands or the environmental conditions or limits, on within, surrounding or near the property at the time of survey.

MAP OF SURVEY
TAX MAP LOT 63 BLOCK 199
BARNEGAT TOWNSHIP
OCEAN COUNTY NEW JERSEY

Date: 3/21/05 Scale: 1"=20' Drawn by: JPH Job No: 03-0721

DOLAN - ENDRISS ASSOCIATES, P.A.

PROFESSIONAL LAND SURVEYORS & PLANNERS
651 Westlacy Road, Forked River, New Jersey 08731
Phone (609) 693-6452 Fax (609) 971-1411

FRANCIS A. DOLAN

N.J.P.L.S. 23920

WILLIAM C. ENDRISS

N.J.P.L.S. 27486