

206/3

Job 7118
O.M.B. No. 3067-0077
Expires July 31, 1999

ELEVATION CERTIFICATE
FEDERAL EMERGENCY MANAGEMENT AGENCY
NATIONAL FLOOD INSURANCE PROGRAM

ATTENTION: Use of this certificate does not provide a waiver of the flood insurance purchase requirement. This form is used only to provide elevation information necessary to ensure compliance with applicable community floodplain management ordinances, to determine the proper insurance premium rate, and/or to support a request for a Letter of Map Amendment or Revision (LOMA or LOMR). You are not required to respond to this collection of information unless a valid OMB control number is displayed in the upper right corner of this form.

Instructions for completing this form can be found on the following pages.

SECTION A PROPERTY INFORMATION		FOR INSURANCE COMPANY USE
BUILDING OWNER'S NAME <u>Michael & Diana Cassidy</u>	POLICY NUMBER	
STREET ADDRESS (Including Apt., Unit, Suite and/or Bldg. Number) OR P.O. ROUTE AND BOX NUMBER <u>5 Creek View Road</u>	COMPANY NAIC NUMBER	
OTHER DESCRIPTION (Lot and Block Numbers, etc.) <u>Tax Lot 3, Block 206 Barnegat Twp., Ocean County New Jersey</u>		
CITY <u>Barnegat</u>	STATE <u>NJ</u>	ZIP CODE <u>08005</u>

SECTION B FLOOD INSURANCE RATE MAP (FIRM) INFORMATION

Provide the following from the proper FIRM (See Instructions):

1. COMMUNITY NUMBER	2. PANEL NUMBER	3. SUFFIX	4. DATE OF FIRM INDEX	5. FIRM ZONE	6. BASE FLOOD ELEVATION (in AO Zones, use depth)
340396	0023	C	12/15/1982	A5	7.0'

7. Indicate the elevation datum system used on the FIRM for Base Flood Elevations (BFE): ☐ NGVD '29 ☐ Other (describe on back)
8. For Zones A or V, where no BFE is provided on the FIRM, and the community has established a BFE for this building site, indicate the community's BFE: feet NGVD (or other FIRM datum—see Section B, Item 7).

SECTION C BUILDING ELEVATION INFORMATION

1. Using the Elevation Certificate Instructions, indicate the diagram number from the diagrams found on Pages 5 and 6 that best describes the subject building's reference level 8.
- 2(a). FIRM Zones A1-A30, AE, AH, and A (with BFE). The top of the reference level floor from the selected diagram is at an elevation of 19.15 feet NGVD (or other FIRM datum—see Section B, Item 7).
- (b). FIRM Zones V1-V30, VE, and V (with BFE). The bottom of the lowest horizontal structural member of the reference level from the selected diagram, is at an elevation of feet NGVD (or other FIRM datum—see Section B, Item 7).
- (c). FIRM Zone A (without BFE). The floor used as the reference level from the selected diagram is feet above ☐ or below ☐ (check one) the highest grade adjacent to the building.
- (d). FIRM Zone AO. The floor used as the reference level from the selected diagram is feet above ☐ or below ☐ (check one) the highest grade adjacent to the building. If no flood depth number is available, is the building's lowest floor (reference level) elevated in accordance with the community's floodplain management ordinance? ☐ Yes ☐ No ☐ Unknown
3. Indicate the elevation datum system used in determining the above reference level elevations: ☒ NGVD '29 ☐ Other (describe under Comments on Page 2). (NOTE: If the elevation datum used in measuring the elevations is different than that used on the FIRM [see Section B, Item 7], then convert the elevations to the datum system used on the FIRM and show the conversion equation under Comments on Page 2.)
4. Elevation reference mark used appears on FIRM: ☐ Yes ☒ No (See Instructions on Page 4)
5. The reference level elevation is based on: ☒ actual construction ☐ construction drawings
(NOTE: Use of construction drawings is only valid if the building does not yet have the reference level floor in place, in which case this certificate will only be valid for the building during the course of construction. A post-construction Elevation Certificate will be required once construction is complete.)
6. The elevation of the lowest grade immediately adjacent to the building is: 16.4 feet NGVD (or other FIRM datum—see Section B, Item 7).


SECTION D COMMUNITY INFORMATION

1. If the community official responsible for verifying building elevations specifies that the reference level indicated in Section C, Item 1 is not the "lowest floor" as defined in the community's floodplain management ordinance, the elevation of the building's "lowest floor" as defined by the ordinance is: feet NGVD (or other FIRM datum—see Section B, Item 7).
2. Date of the start of construction or substantial improvement .

This certification is to be signed by a land surveyor, engineer, or architect who is authorized by state or local law to certify elevation information when the elevation information for Zones A1–A30, AE, AH, A (with BFE), V1–V30, VE, and V (with BFE) is required. Community officials who are authorized by local law or ordinance to provide floodplain management information, may also sign the certification. In the case of Zones AO and A (without a FEMA or community issued BFE), a building official, a property owner, or an owner's representative may also sign the certification.


Reference level diagrams 6, 7 and 8 - Distinguishing Features—If the certifier is unable to certify to breakaway/non-breakaway wall, enclosure size, location of servicing equipment, area use, wall openings, or unfinished area Feature(s), then list the Feature(s) not included in the certification under Comments below. The diagram number, Section C, Item 1, must still be entered.

I certify that the information in Sections B and C on this certificate represents my best efforts to interpret the data available.
I understand that any false statement may be punishable by fine or imprisonment under 18 U.S. Code, Section 1001.

CERTIFIER'S NAME		LICENSE NUMBER (or Affix Seal)	
Robert W. Smith		PLS 23934	
TITLE		COMPANY NAME	
Professional Land Surveyor		Gravatt Geller & Associates	
ADDRESS		CITY	STATE ZIP
P.O. Box 810		Freehold	NJ 07728
SIGNATURE		DATE	PHONE
		1/3/00	(732) 462-8333

Copies should be made of this Certificate for: 1) community official, 2) insurance agent/company, and 3) building owner.

COMMENTS: This does not certify the location or elevation of any utilities servicing this dwelling, which may or may not be above the base flood elevation. Attached garage floor elevation = 6.9, A/C pad elevation = 9.5.

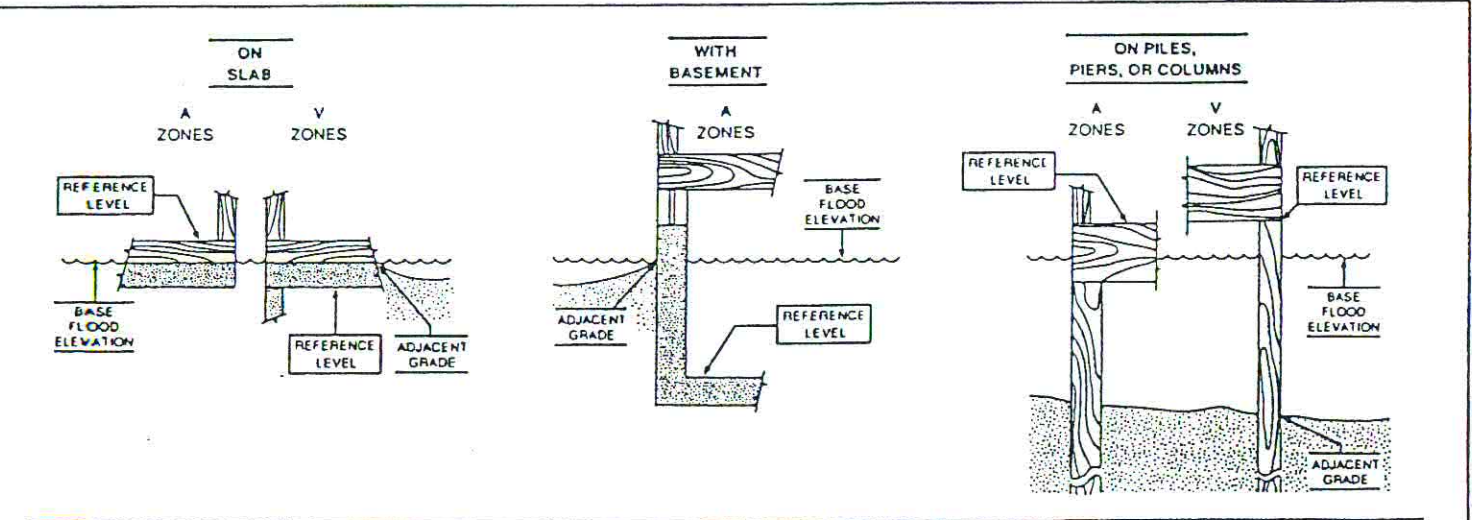


The diagrams above illustrate the points at which the elevations should be measured in A Zones and V Zones.
Elevations for all A Zones should be measured at the top of the reference level floor.
Elevations for all V Zones should be measured at the bottom of the lowest horizontal structural member.

LEGEND

- ⊙ = IRON PIPE FOUND
- = CAPPED REBAR FOUND
- UTILITY POLE W/OVERHEAD WIRES
- — — CONTOUR
- ≡ ELEVATION

NOTES :

1. PROPERTY ALSO KNOWN AS LOT 17 AS SHOWN ON A CERTAIN MAP ENTITLED "SECTION NO. 1 SUBDIVISION MAP OF SEAMANS SHORES IN BARNECATT ~ UNION TOWNSHIP ~ OCEAN COUNTY ~ NEW JERSEY" FILED IN THE OCEAN COUNTY CLERK'S OFFICE ON AUGUST 26, 1958 AS MAP NO. A-421.
2. NO INVESTIGATION WAS MADE CONCERNING SUBSURFACE CONDITIONS OR THE EXISTENCE OF UNDERGROUND OR OVERHEAD CONTAINERS OR FACILITIES WHICH MAY AFFECT THE USE OR DEVELOPMENT OF THIS TRACT.
3. THIS DRAWING DOES NOT IDENTIFY OR CERTIFY THE EXISTENCE OF ANY WETLANDS OR ANY AREAS NOW OR FORMERLY FLOWED BY TIDEWATERS BEING CLAIMED BY THE STATE OF NEW JERSEY, WHICH MAY OR MAY NOT BE PRESENT ON SITE.
4. EXCEPT AS SPECIFICALLY STATED OR SHOWN ON THIS PLAN, THIS SURVEY DOES NOT PURPORT TO REFLECT ANY OF THE FOLLOWING WHICH MAY BE APPLICABLE TO THE SUBJECT REAL ESTATE: EASEMENTS, OTHER THAN POSSIBLE EASEMENTS WHICH WERE VISIBLE AT THE TIME OF MAKING OF THIS SURVEY; BUILDING SETBACK LINES; RESTRICTIVE COVENANTS; SUBDIVISIONS RESTRICTIONS; ZONING OR OTHER LAND-USE REGULATIONS; AND ANY OTHER FACTS WHICH AN ACCURATE CURRENT TITLE SEARCH MAY DISCLOSE.
5. OFFSETS AS SHOWN HEREON ARE NOT TO BE USED FOR CONSTRUCTION OF FENCES OR OTHER PERMANENT STRUCTURE AND OR THE PLACEMENT OF ACCESSORY BUILDINGS.
6. ALL ELEVATIONS ARE BASED ON N.G.V.D. OF 1929.
7. PROPERTY FALLS WITHIN FLOOD ZONE AS ELEVATION 7.0, AS SHOWN ON FLOOD INSURANCE RATE MAP FOR BARNECATT TWP. OCEAN COUNTY, N.J., COMMUNITY PANEL NUMBER 340366 0023 C, EFFECTIVE DATE DEC. 15, 1982.

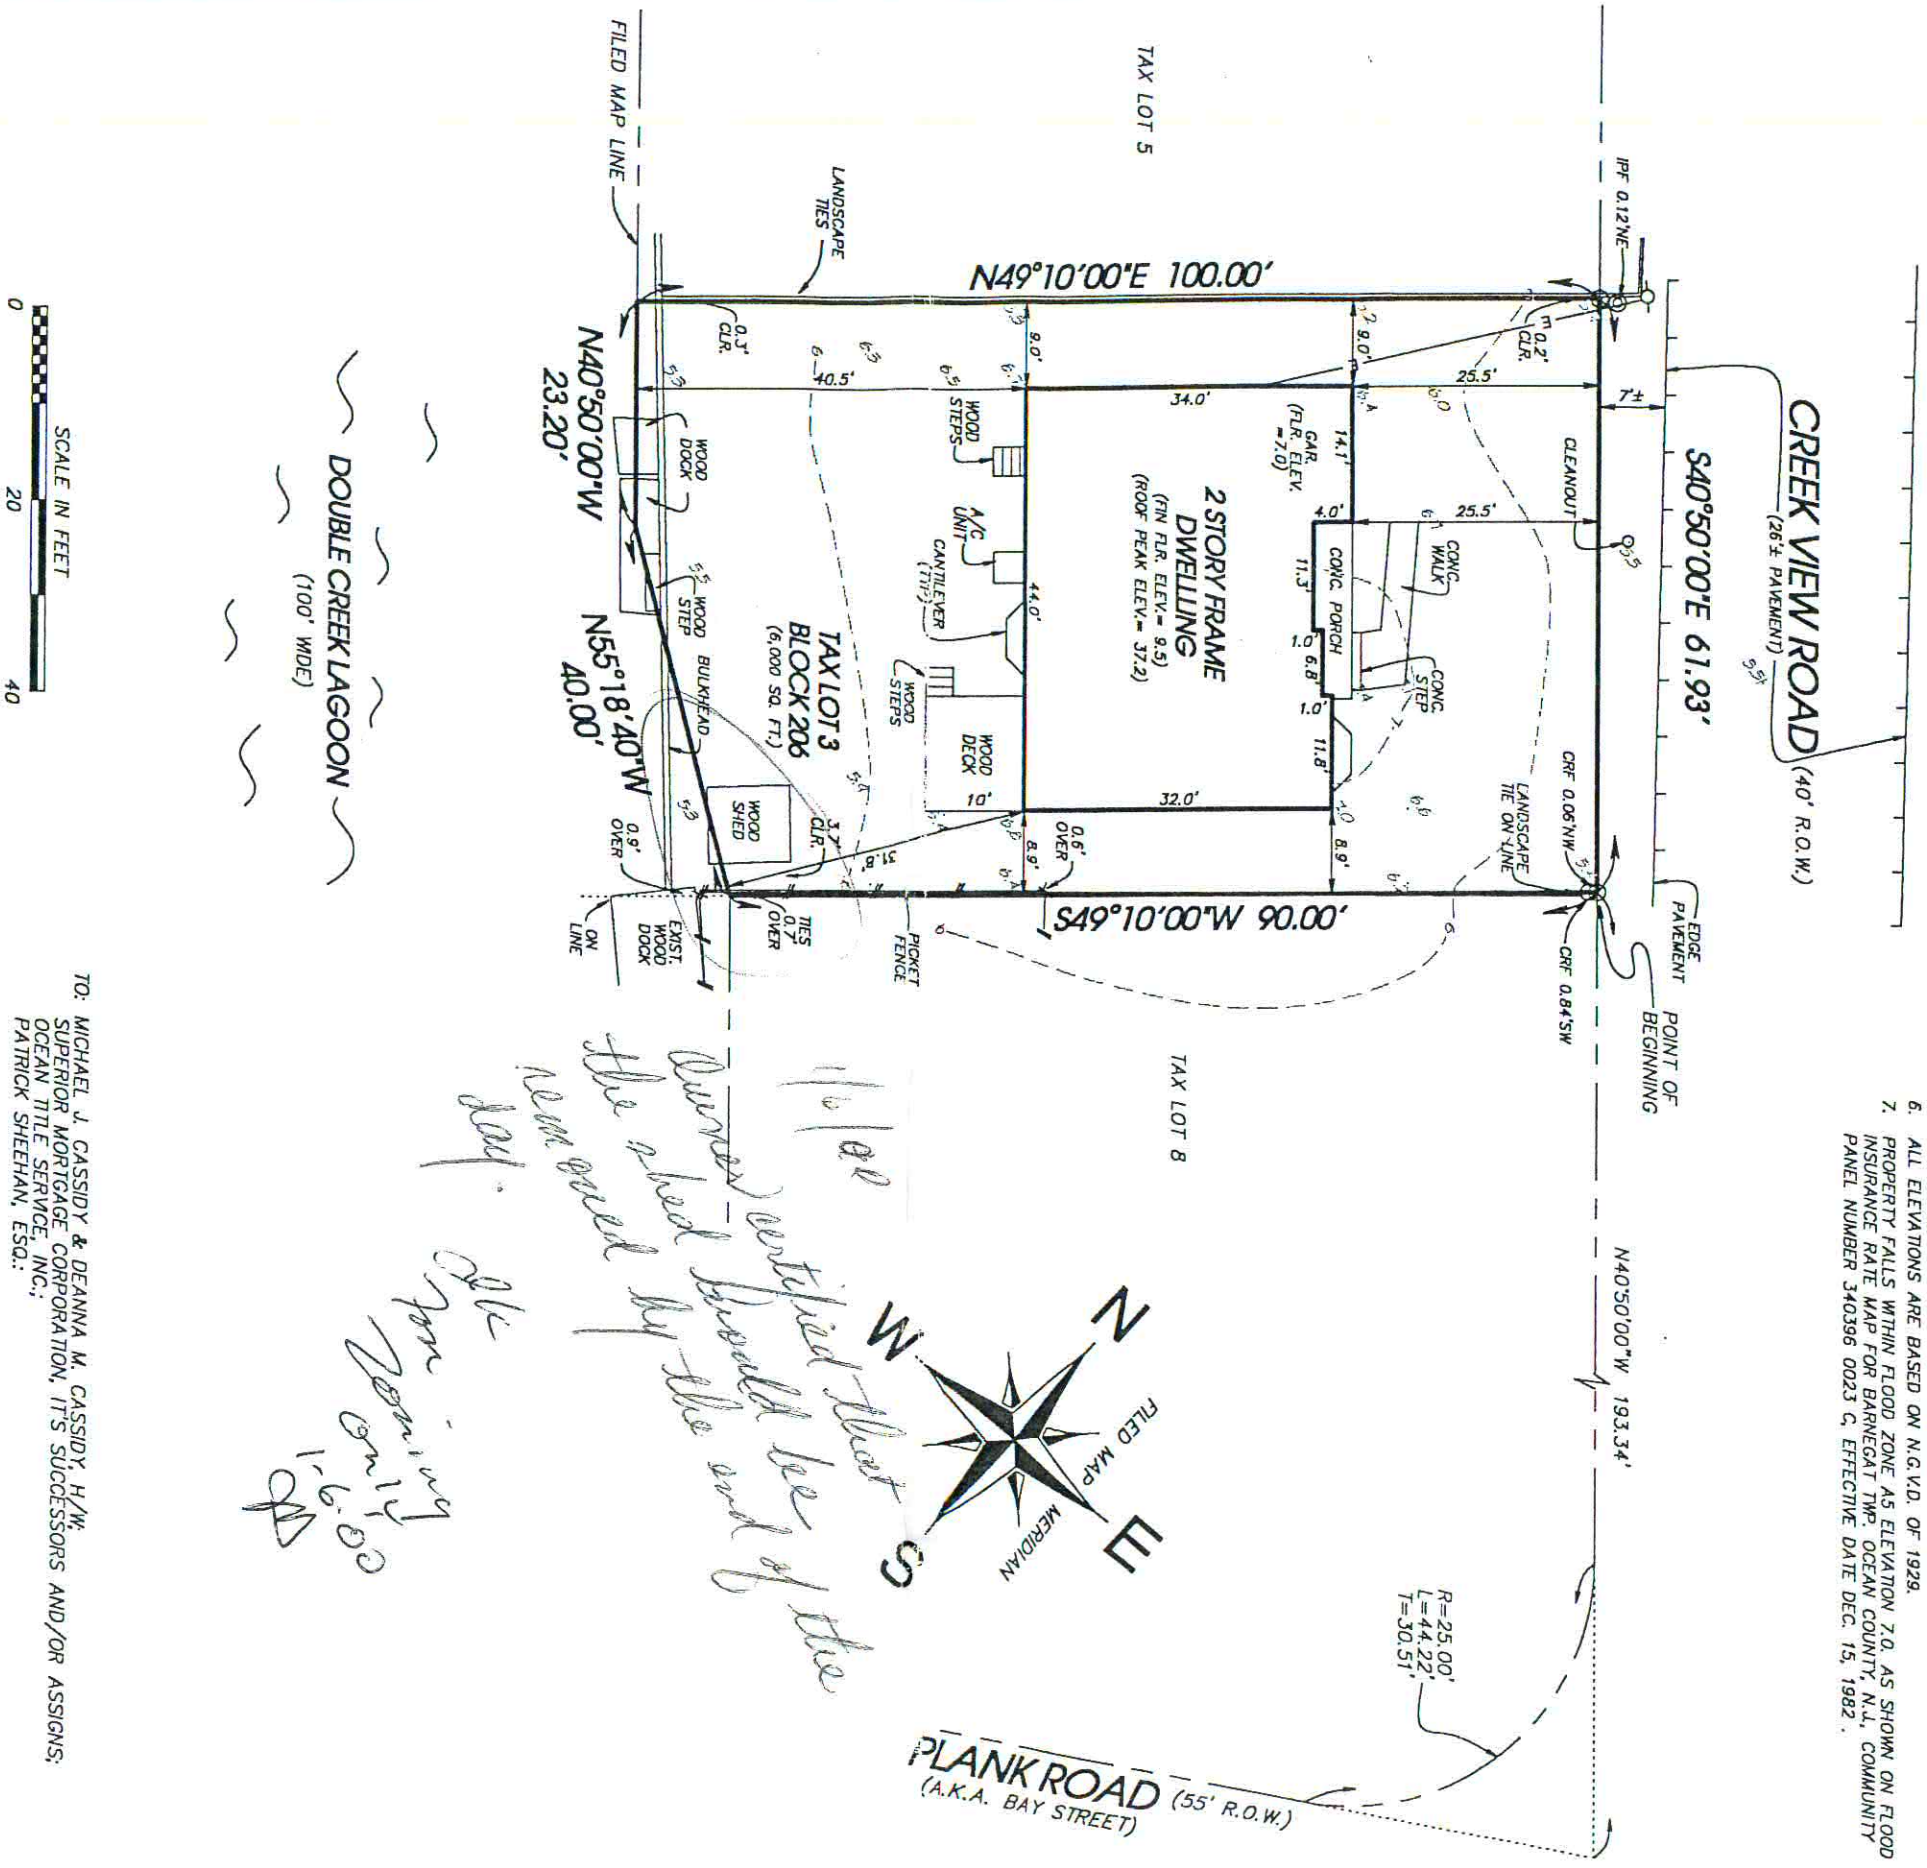

ASBUILT MAP OF SURVEY

TAX LOT 3 BLOCK 206

BARNEGAT TOWNSHIP

OCEAN COUNTY, NEW JERSEY

SCALE: 1" = 20'

DATE: JAN. 3, 2000

CHECKED BY:

SHEET NO. 1 OF 1

PROJECT NUMBER

7118

TO: MICHAEL J. CASSIDY & DEANNA M. CASSIDY H/W,
SUPERIOR MORTGAGE CORPORATION, ITS SUCCESSORS AND/OR ASSIGNS,
OCEAN TITLE SERVICE, INC.,
PATRICK SHEEHAN, ESQ.

This is to certify that this survey is accurate and that this drawing is a true representation of actual conditions existing on the property, except such easements, if any that may be located below the surface of the lands, or on the surface of the lands and not visible. This certification is made only to herein named parties for purchase and/or mortgage of herein delineated property. No responsibility or liability is assumed by Surveyor for use of survey for any other purpose including, but not limited to use of survey for survey affidavit, resale of property or to any other person not listed in certification, either directly or indirectly.

[illegible]

Robert W. Smith Jr.
N.J. Professional Land Surveyor No. 25934

1/4/2000
DATE

DATE _____